

# CONSTRUCTION NOTES

- ✓ 1. PRIME CONTRACTOR LICENSE REQUIRED: CLASS A OR C12.

## CONSTRUCTION SYMBOLS


○ 2" P4 ABOVE LINE: INDICATES THE TYPE OF STANDARD OR THICKNESS OF SURFACE MATERIAL IN INCHES; STD PLAN VARIABLES; CURB RAMP CASE, TYPE, SECTION AND DETAIL; OR TREE PLANTING CASE

## CONSTRUCTION LEGEND


- ⑧ ASPHALT CONCRETE PAVEMENT
- ⑬ COLD MILL ASPHALT CONCRETE PAVEMENT
- ②② ASPHALT RUBBER HOT MIX (ARHM)
- ②⑦ DOUBLE ADJUST MANHOLE
- ③⑧ IMPORTED BORROW
- ④⑦ BONDED WEARING COURSE
- ⑦⑦ ASPHALT RUBBER AGGREGATE MEMBRANE INTERLAYER (ARAM)

## AC PAVEMENT CLASS AND GRADE LEGEND


P1 C2-PG 64-10      P3 B-PG 64-10  
B-PG 64-10  
P2 C2-PG 64-10      P4 D2-PG 64-10

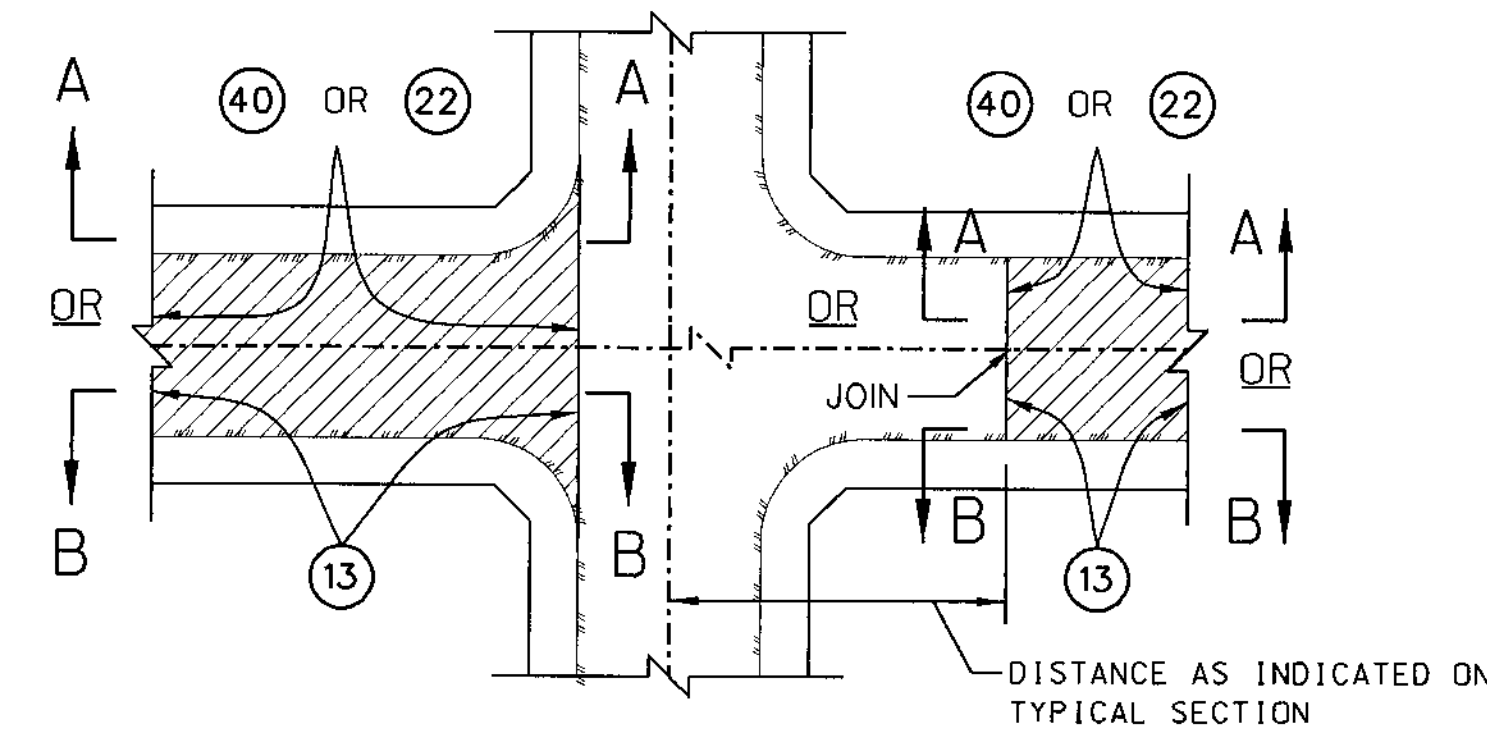


JOIN DETAIL A  
TYPICAL AC PAVEMENT JOIN DETAIL  
NO SCALE

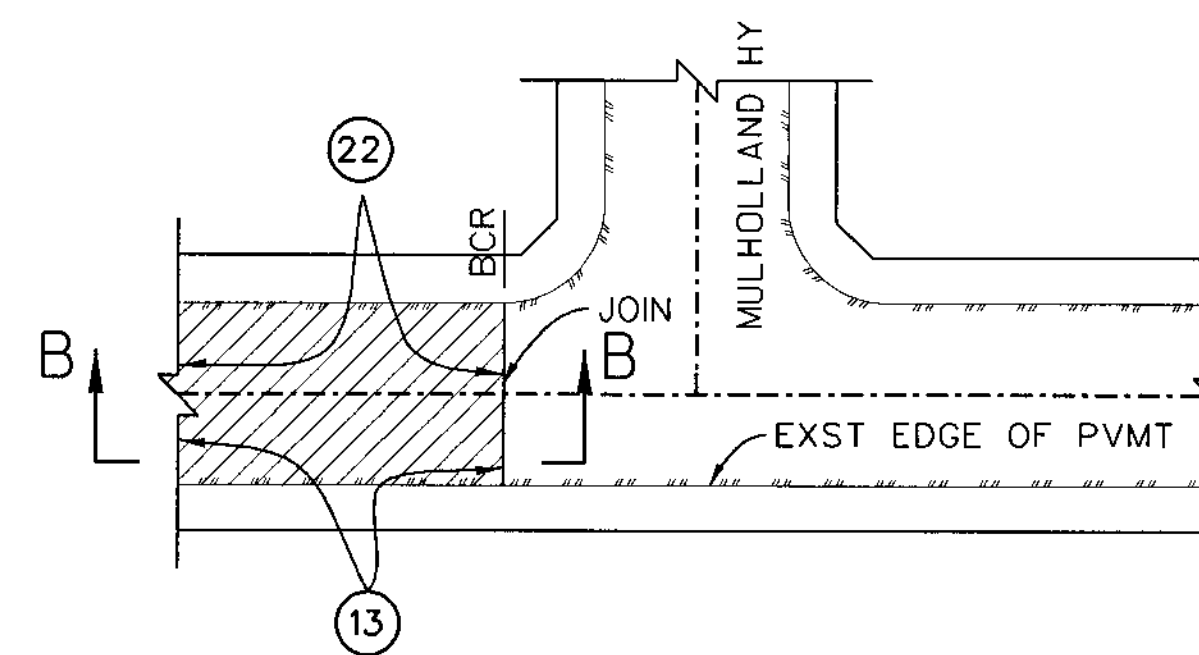


JOIN DETAIL B  
TYPICAL AC PAVEMENT JOIN DETAIL  
NO SCALE

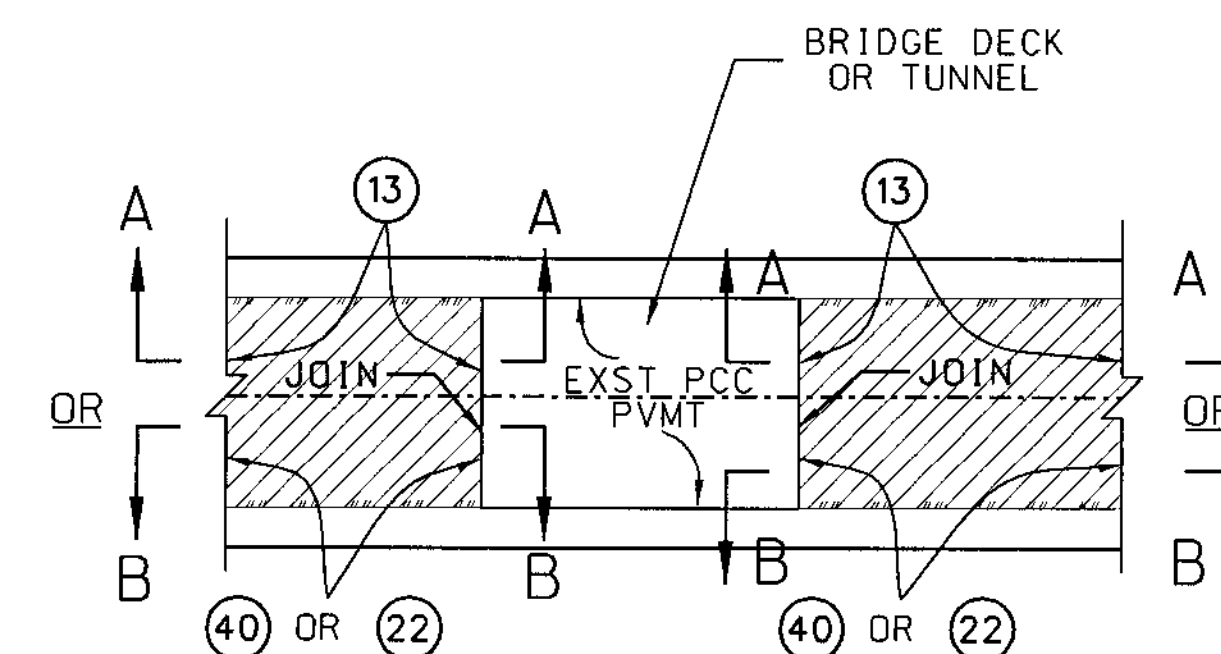


JOIN DETAIL C  
TYPICAL AC PAVEMENT  
BRIDGE DECK OR TUNNEL JOIN DETAIL  
NO SCALE

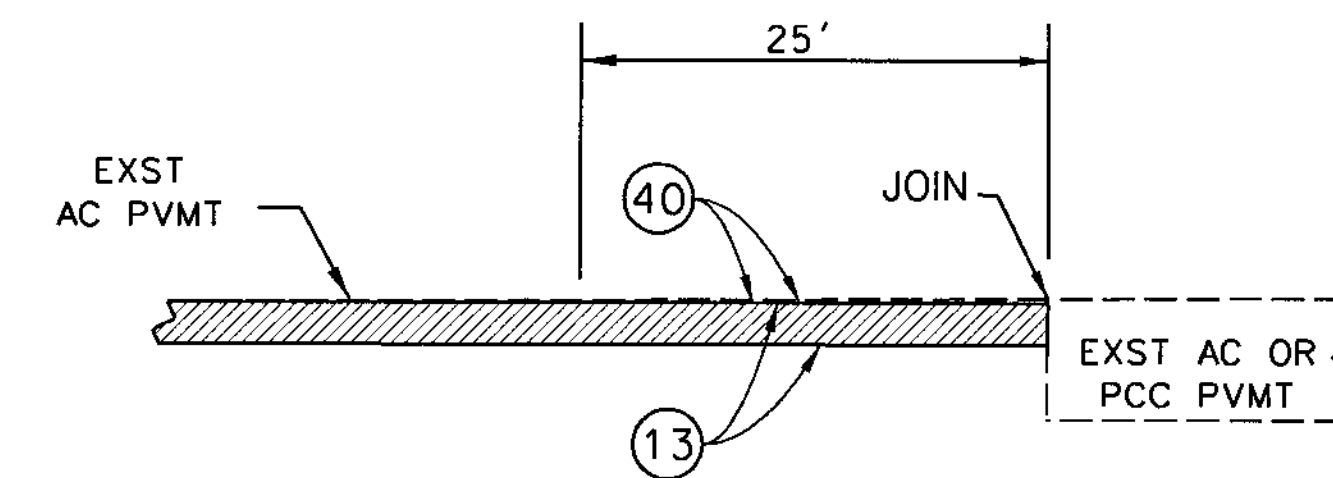

SECTION A-A  
NO SCALE  
TYPICAL TRANSVERSE JOIN DETAIL

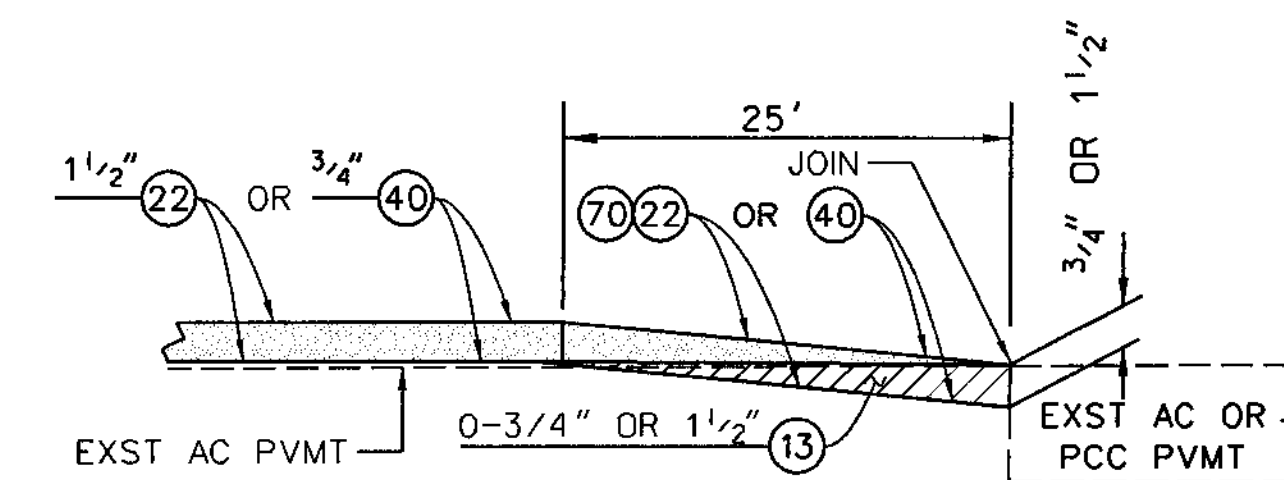

SECTION B-B  
NO SCALE  
TYPICAL TRANSVERSE JOIN DETAIL

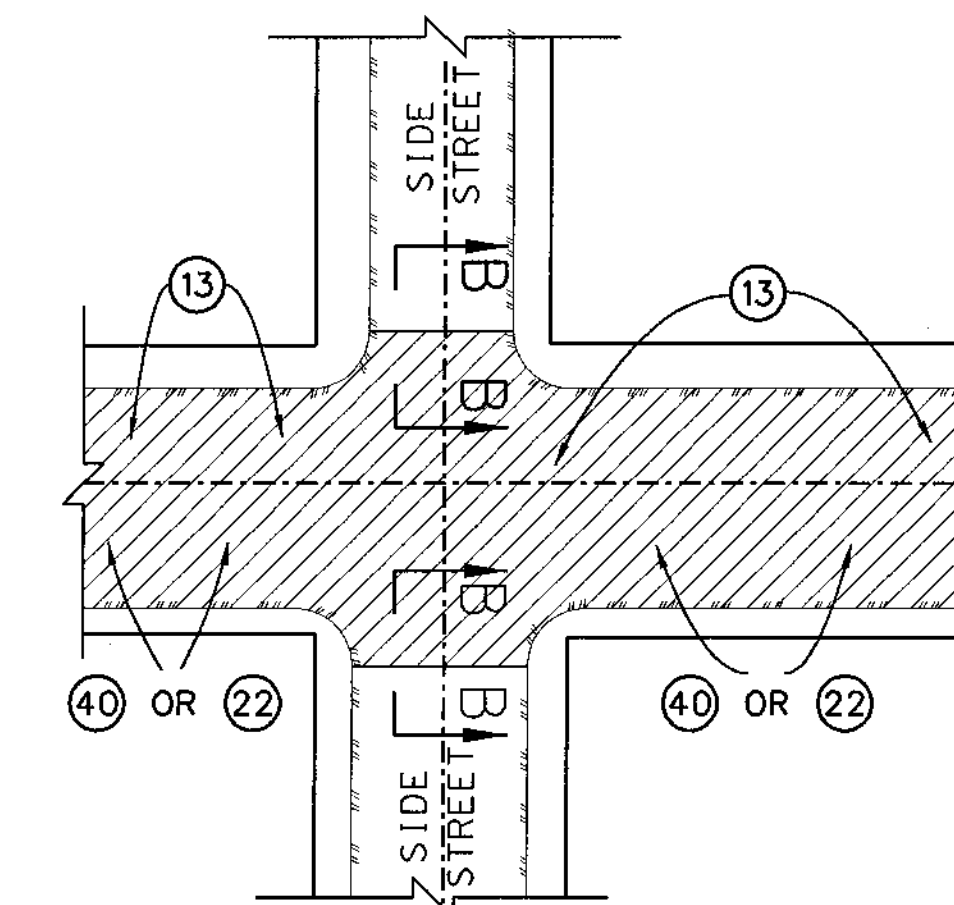

JOIN DETAIL D  
TYPICAL PAVE THRU  
INTERSECTION JOIN DETAIL  
NO SCALE

AS-BUILT



PLAN B

COUNTY OF LOS ANGELES DEPARTMENT OF PUBLIC WORKS MULHOLLAND HIGHWAY, ET AL. NOTES, REFERENCES, AND DETAILS PROJECT ID NO. RDC0015194 PREVENTIVE MAINTENANCE PROJECT			JOB X2301682 DWG SHEET 2 OF 5
DATE: 6/4/09 MK: [blank] DESCRIPTION: [blank]			PROJECT ENGINEER: [signature] DATE: 6/4/09

CHECKED: V. LLANA  
 DESIGNED: E. M.  
 DRAFTER: E. M.  
 REVIEWED: [signature]  
 DATE: 6/4/09  
 BY: [signature]

PROPOSED FOR CONSTRUCTION: [blank]  
 ADVERTISED: [blank]  
 AS BUILT: [blank]